


NOTES:
 1. REFER TO WD-6001 FOR DRAWING INDEX, SETOUT DETAILS, GENERAL NOTES AND LEGEND.
 2. REFER TO WD-6002 FOR SET OUT TABLES.

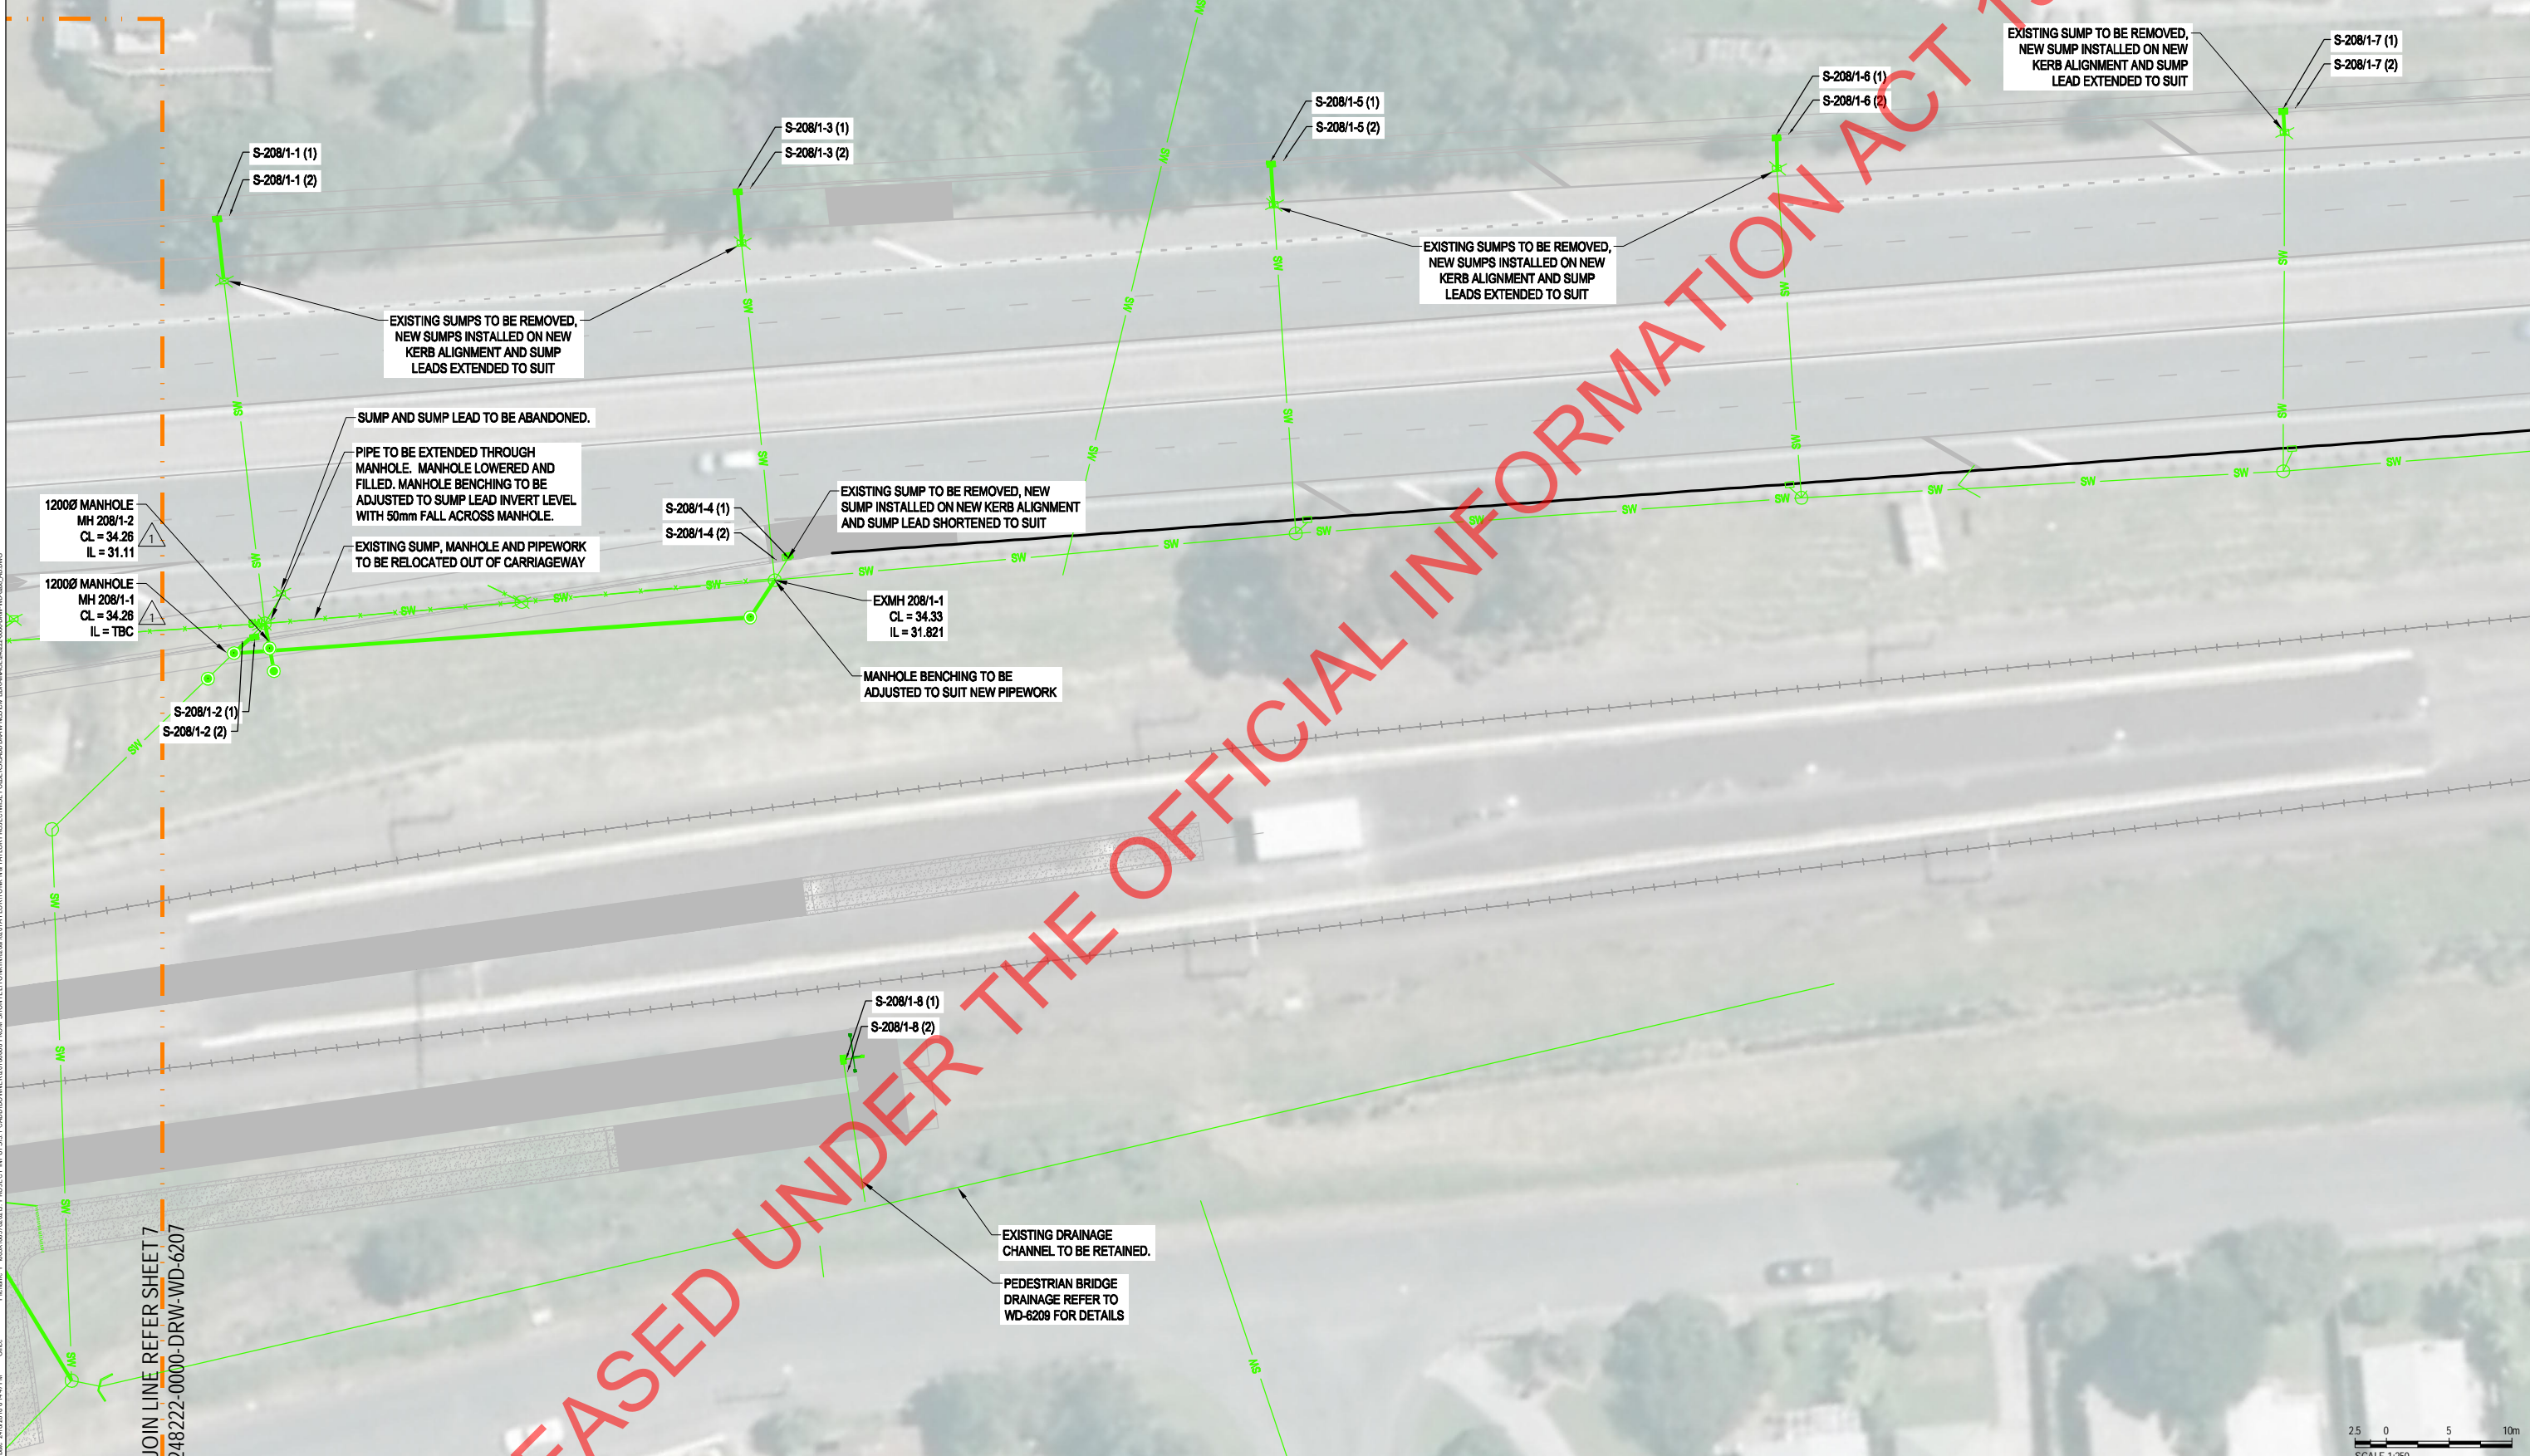

File Name: P:\A05\A05182003_PROJECT INPUT\311_CADD\DOWNLINE\DRW\NS\CV\URBAN\AGE\36222\DRW\WD-6208_AB.DWG
 Plot Date: 24/02/2018 6:14:07 AM
 Office:

JOIN LINE REFER SHEET 7
 248222-0000-DRW-WD-6207

RELEASED UNDER THE OFFICIAL INFORMATION ACT 1982



REV	DATE	REVISION DETAILS	APPROVED
AB	29.06.18	AS BUILT	

SCALE	SIZE
1:250	A1
DRAWN	
s9(2)(a)	
DESIGNED	
s9(2)(a)	
CHECKED	
s9(2)(a)	

AS BUILT	APPROVED	DATE

PROJECT	SH2 - SH58 HAYWARDS INTERCHANGE
TITLE	STORMWATER DRAINAGE LAYOUT PLAN SHEET 8 OF 8
DRAWING No.	248222
PROJECT No.	0000
WBS	0000
TYPE	DRW
DISC	WD
NUMBER	6208
REV	AB